



1918

1918

1918

REQUISITION FOR AUTHORITY FOR EXPEND

Applicant's No. 148 Eng. Dept. No. 2-1918 Comptrol  
On Yellowstone Div'n or Location Operating Dept. State of Dakota  
Authority is requested for an expenditure of \$ 1067.00 che

follows: (Distribution to be made in General Office, St. Paul.)  
To Optg. Exps. \$ 130.00 To Adms. and Betts. \$ 888.00 To

For ~~additions~~ ~~improvements~~ ~~replacements~~ at Second District ~~In Budget~~ ~~Not in Budget~~ ~~Out of Budget~~

Consisting of Estimated cost of proposed riprap and of protect roadbed




The location is on this company's property and is not in joint territory. it will be necessary to do nothing.

# 1

If required by Accounting Department, a detailed estimate will be furnished. The expenditure is recommended for the following reasons: (if space is not su)

At the points indicated on the attac print, the streams are cutting into the r riprapping is necessary to protect the ro

This has been looked over on the gro Division Engineer and Division Superinten is their joint recommendation that the wo

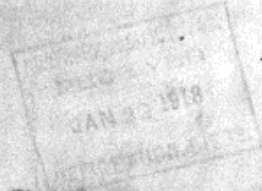

Work should be commenced at once in order to complete by and be done by company force under charge of Division Supe


Signature and Title of Applicant: H Jacobs Supt Date of Requisition

APPROVED By: [Signature] Genl. Supt. [Signature] Engr. Mgr W.

[Signature] Chief Engr., Mech. Supt. or Supt. Telg. [Signature] First Vice President.

[Signature] Comptroller. [Signature] President. Date of Final Approval

COMPTROLLER'S RECORD OF NOTICE OF APPROVAL AND OF


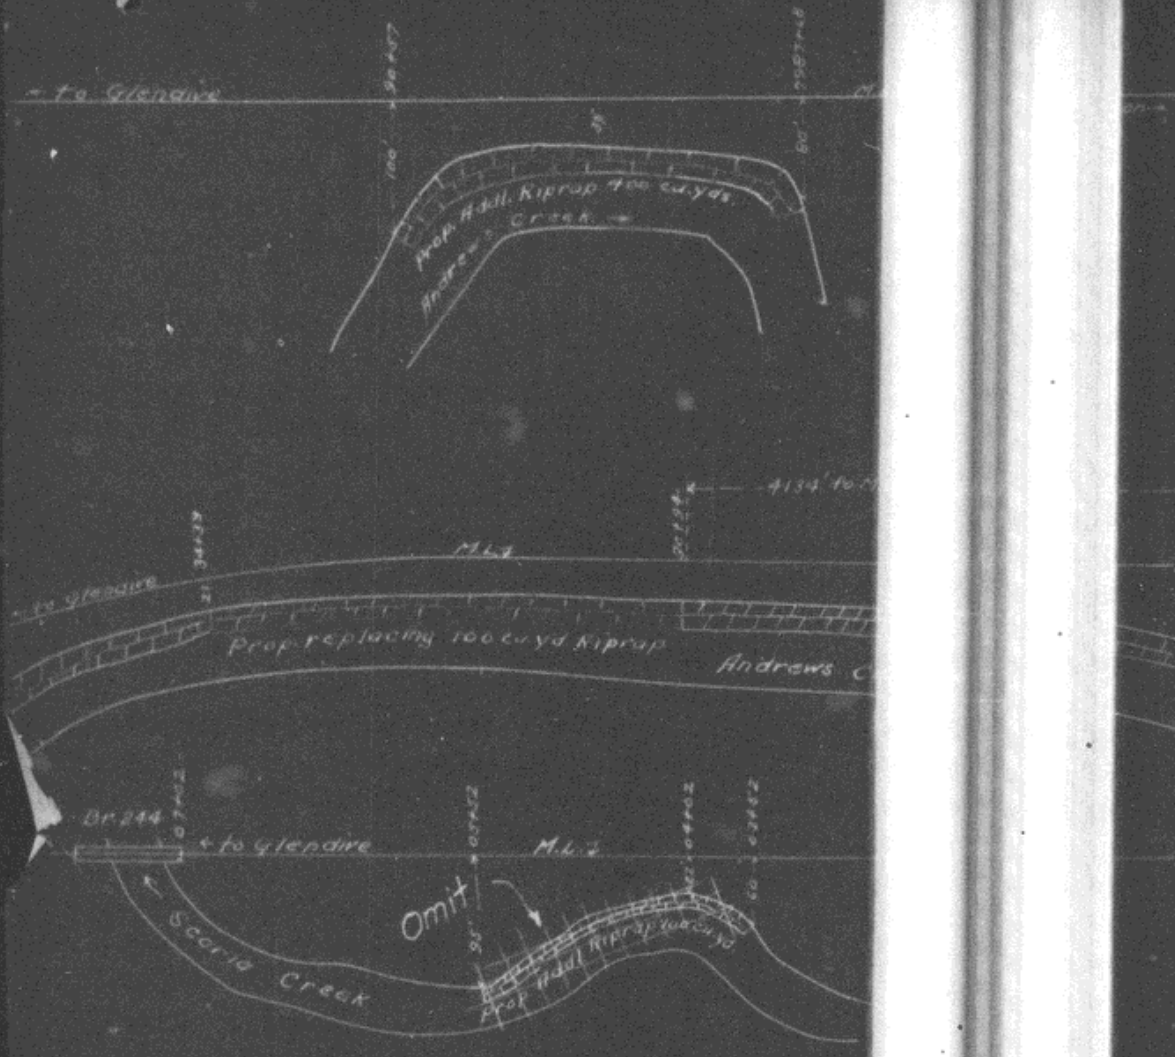


Yell. Div. N.P.Ry. 2nd Dist.

Proposed Riprap to protect Road  
at

~~M.P. 147+4192~~  
M.P. 157+4134  
M.P. 151+1480

Scale 1"=100'  
Office of Fluv. Engr. Glendive Mont. 9-12-1911  
Valuation Section North Dakota No. 1  
Plans under Impt. No. dated  
Work begun  
Work completed.

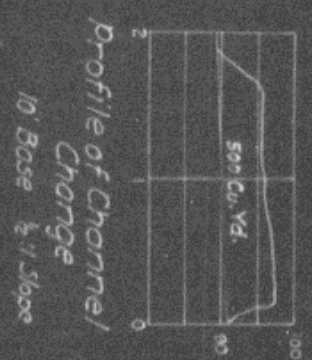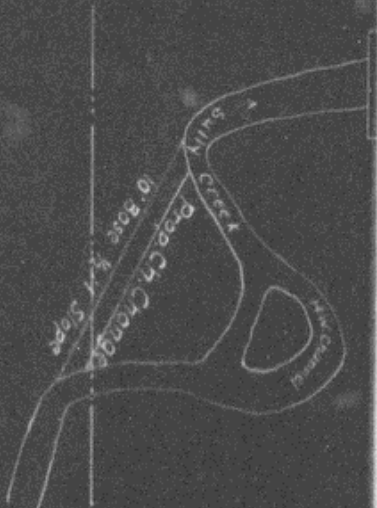

N.P.S.  
 Y.H.D.W.  
 Proposed Channel Change  
 of

MP14714365

Scale 1"=100'

Office of Water Resources Management  
 Water Section, Water Data's, Vol. \_\_\_\_\_  
 Date \_\_\_\_\_  
 Work completed \_\_\_\_\_