

1918
REQUISITION FOR AUTHORITY FOR EXPENDITURE

(Form 1365)

Applicant's No. 15 Eng. Dept. No. 8 Comptroller's No. 10
 On Minnesota Div'n or Operating Dept. State of Minn Val. Sec. No. 17

Author is requested for an expenditure of \$ 92.00
 follow (Distribution to be made in General Office, St. Paul.) chargeable approximately as

Optg. Equip. ~~REMOVED~~ To Addns. and Betts. \$ 902.00 ✓ To M&S \$ 399.00 ✓
 DEPRECIATION DOCUMENT 15700

Consisting of Taking up Abandoned Trackage. Staples and Lake Park, Minnesota.
 Original Cost Adjustment
 Made in April 1918

The location is on ~~not on~~ this company's property and is not in joint territory. To secure required rights it will be necessary nothing necessary.

If required by Accounting Department, a detailed estimate will be furnished promptly after approval. The expenditure is recommended for the following reasons: (if space is not sufficient continue on back.)

It is recommended taking up the abandoned Staples Mill Spur, the mill being burned down and will never be re-builder track used; also the abandoned portion of the old High Line Track at Lake Park which will never be used, thus making material available where needed. We can do the work any time.

RECEIVED
 JAN 24 1918
 OFFICE SUPER. ENGRS.

ENTERED
 Budget Record

Work should be commenced soon in order to complete as soon as possible
 and be done by contract under charge of Superintendent

Signature and Title of Applicant } E. J. Macomber Date of Requisition } January 4th, 1918
 Superintendent


APPROVED BY
Chihito Genl. Supt.
W. J. ... Engr. M. of W.
A. M. ... Chief Engr. M. of W.

... Chief Engr., Mech. Supt. or Supt. Telg.
... General Manager.


... First Vice President.
... Second Vice President.
... Comptroller.
 Date of Final Approval } 1918

COMPTROLLER'S RECORD OF NOTICE OF APPROVAL AND OF COMPLETION

Form 1845 issued 1918 Work begun 1918 Work finished 1918

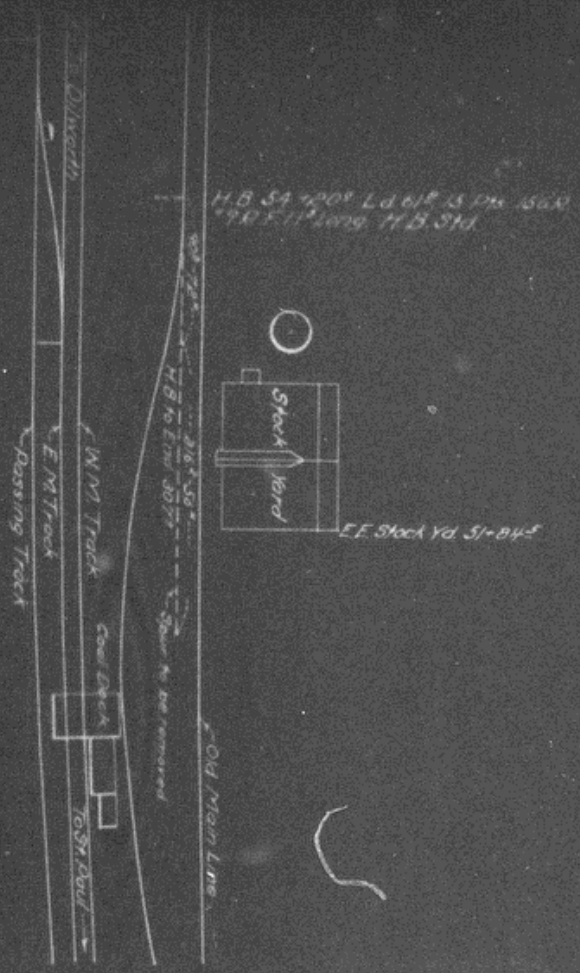

Lake Park

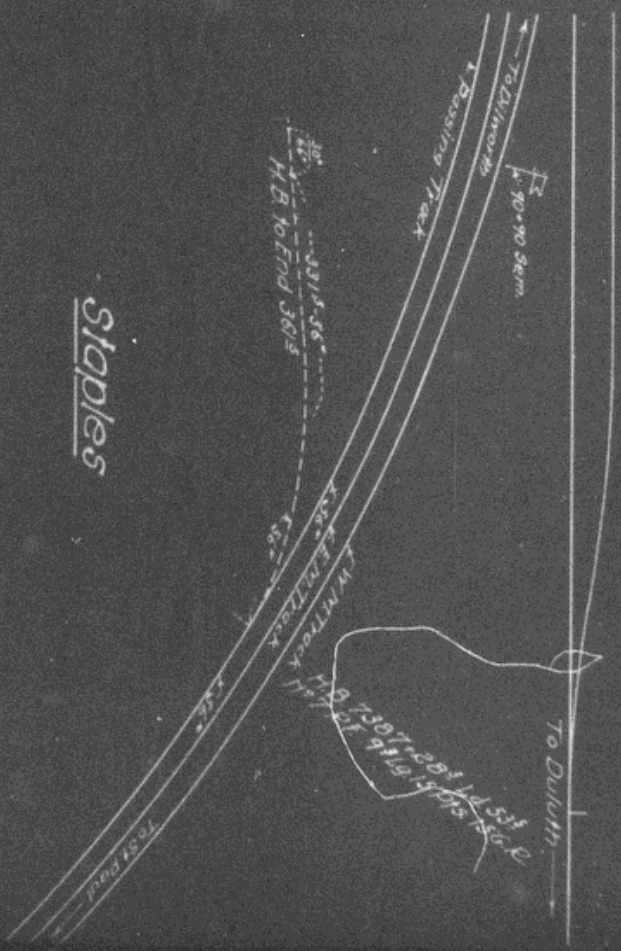

Staples

MIM DIVY Sketch Showing
 Main Line
 Removal of unused Tracks
 Staples and Lake Park
 Scale: 1"=100'
 Office of Div'n Engr. St. Paul, Nov 24/17
 Work to be removed shown dotted lines
 Vel. Sec. 11917/11111