

1925

COMPTROLLER'S COPY

NORTHERN PACIFIC RAILWAY COMPANY

AUTHORITY FOR EXPENDITURE

Year: 1924

Superintendent's No. 112
No.

Dept. No. Engineering Dept. No. 143

A. F. E. No. 2

DEPRECIATION
DOCUMENT 1-15-1928
ENTERED IN
EXHIBIT

Superior Div. Second District State Minn. Val. Sec. No. 12

AUTHORITY IS REQUESTED FOR A NET EXPENDITURE OF \$ 822.00

Accounting distribution as follows: (Distribution to be made in General Office.)

	Operating Expenses	Profit and Loss	Net Operating Expenses	Net Profit and Loss
Cost of property retired	\$ 283	\$	\$	\$
Value of salvage				
Incidental costs			283	
Total to Operating Expenses				\$ 283
Total to Profit and Loss				
To Material and Supplies				
To Bills for Collection				
To Other Accounts				
Net charge to investment account—Additions and Betterments				539
Total of distribution				\$ 822

Budget reference: **Not in Budget**

Class of Work: No. 20

Joint facility contract reference: **Not Joint Account**

The location is — — — on this company's property. To secure rights, it will be necessary to acquire

Location: Opomwall

The discharge pipe at the water station, (of 5 inch wrought iron material) has been in service for about 15 years, is badly corroded and quite often springs a leak, which necessitates expense of digging it up for repairs. The last time that the pipe was uncovered, the inspection indicated the pipe would hardly last through the winter and therefore it is proposed to replace this pipe with Class A cast iron pipe, in order to put the water plant in first class condition.

RECEIVED
DIVISION OF ENGINEERING

RECEIVED
JAN 10 1925

Work to be done by company force under charge of Superintendent contract


Accounting to concentrate in the office of Superintendent

Signature and Title: [Signature] Superintendent Date Dec. 8 1924.

APPROVED: <u>[Signature]</u> General Superintendent.	<u>[Signature]</u> Chief Engineer of Engr. Maint. of Way.	<u>[Signature]</u> Assistant General Manager.
<u>[Signature]</u> Mech. Supt., Supt. Telgr. or Signal Engr.	<u>[Signature]</u> Chief Engineer.	<u>[Signature]</u> Vice President.
<u>[Signature]</u> For Comptroller.	<u>[Signature]</u> President.	Date of Final Approval } JAN 10 1925

COMPTROLLER'S RECORD OF NOTICE OF APPROVAL AND OF COMPLETION

Form No. 1345 issued 19..... Work begun 19..... Work finished March 21 19 25

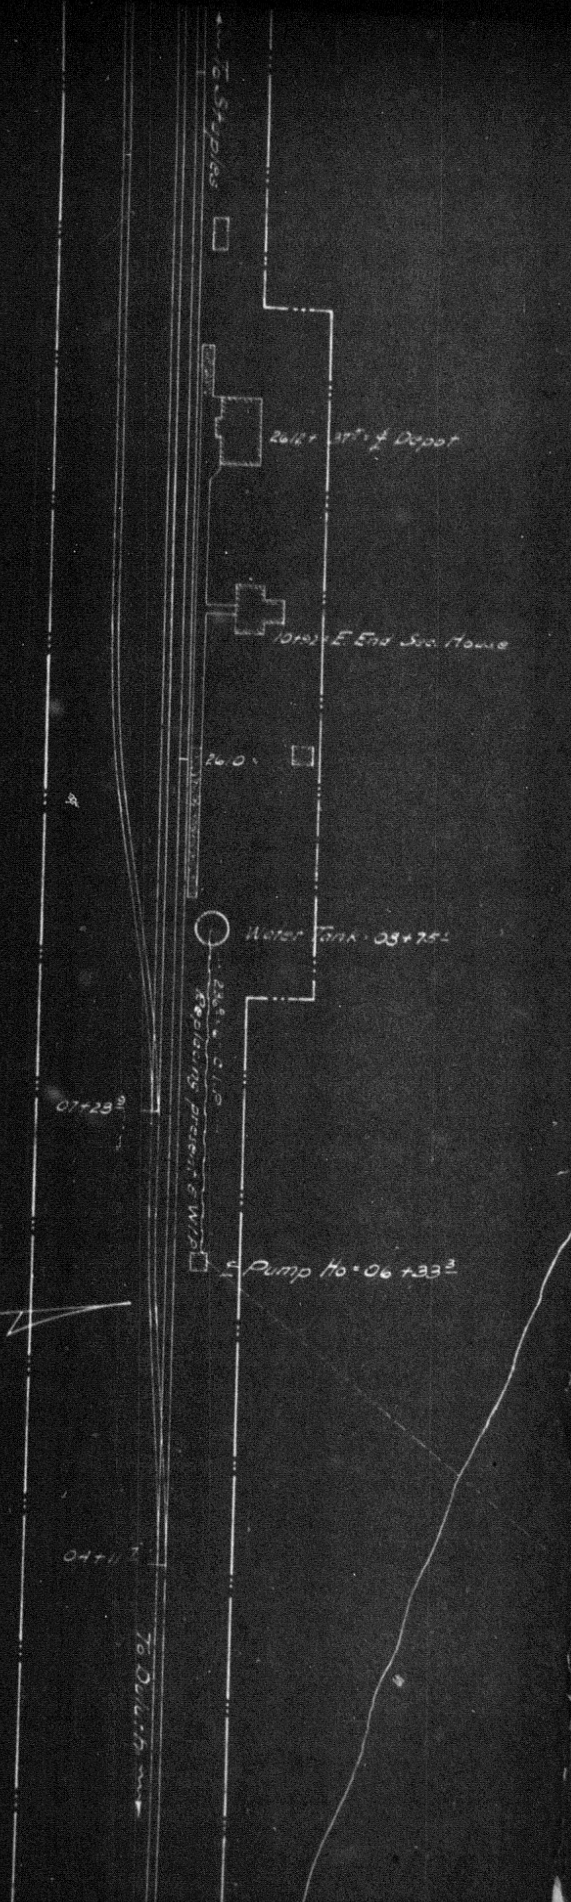

N.P.R.P.

Lake Supr. Div. 2nd Dist.

Prop. replacing of present 5" discharge pipe
with 6" C.I.P. at Cromwell, Minn.

Scale 1" = 100'

Office Dist. Engr. St. Paul, Nov. 24, 1924.
Prop. work shown in Red.

Valuation Sec. No. 12-Minn.