

NORTHERN PACIFIC RAILWAY COMPANY

AUTHORITY FOR EXPENDITURE

Year **1921**

Superintendent's No. **127**

Dept. No.
 Engineering Dept. No. **189(20)**

A. F. E. No. **13**

IDAHO

Div. **SECOND**

District ~~Fourth~~ State **WASHINGTON** Val. Sec. No. **1 - B**

AUTHORITY IS REQUESTED FOR A NET EXPENDITURE OF \$ **537**

Accounting distribution as follows: (Distribution to be made in General Office)

	Operating Expenses	Fruit and Loss	Net Operating Expenses	Net Fruit and Loss
Cost of property retired	\$	\$	\$	\$
Value of salvage				
Incidental costs				
Total to Operating Expenses				\$
Total to Fruit and Loss				
To Material and Supplies				
To Bills for Collection				
To Other Accounts				
Net charge to investment account - Additions and Betterments				\$ 537.
Total of distribution				\$ 537.

Budget reference *See Budget*

Class of Work - No. **1**

Joint facility contract reference

The location is _____ on this company's property. To secure rights, it will be necessary

Location: **PARKWATER, WASHINGTON.**

Title: **BLACKSMITH SHOP TO REPLACE TEMPORARY BUILDINGS DESTROYED BY FIRE.**

Reason: **A temporary blacksmith shop of old scrap material was constructed at this place some years ago without formal authority and there has been no record of this building on our valuation accounts. The building was burned down recently, making it necessary that a new building 22' x 36' be constructed in its place. This work has been done and the accompanying estimate is made to cover the building complete including the present frame work of second hand material.**

The new building was completed on October 27th, 1920.

Adjustment of original cost handled on 10/27/20

Work ~~was~~ done by company force under charge of **DIVISION SUPERINTENDENT**

Accounting to concentrate in the office of **DIVISION SUPERINTENDENT**

Signature and Title _____ Date **November 12th 19 20tg**


APPROVED: _____
General Superintendent, Prin. Asst. Engr. or Engr. in Charge of Way, Assistant General Manager.

_____ Mech. Supt. Supt. Trng. or Signal Engr.

_____ Chief Engineer, General Manager, Vice President.

_____ Date of Final Approval _____ 19 _____

COMPTROLLER'S RECORD OF NOTICE OF APPROVAL AND OF COMPLETION

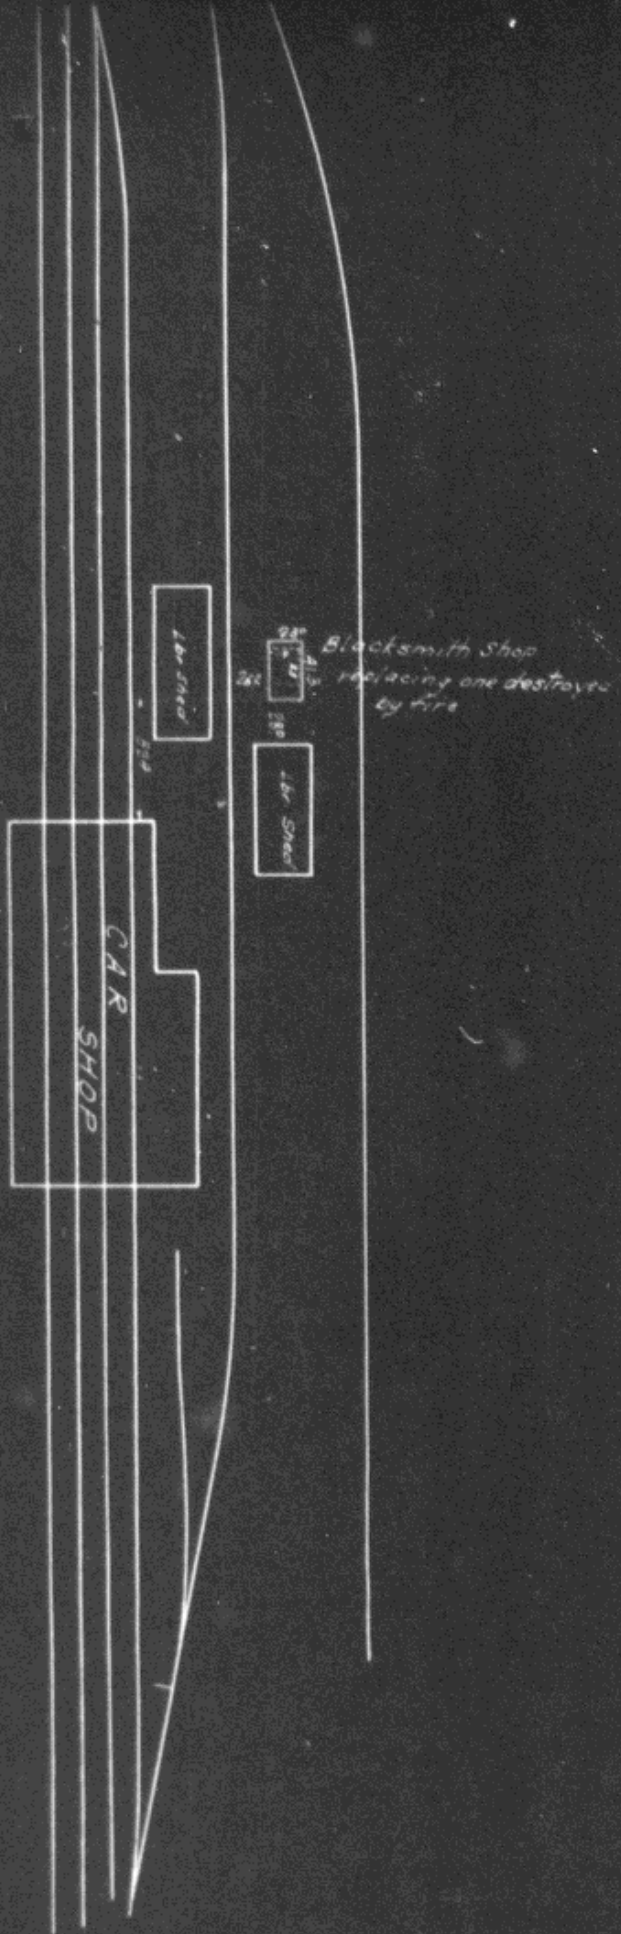

N.P.Ry.
 Idaho Div. 2nd. Subdiv.
 Wash. Valuation Sect. No. 13.
 Blacksmith shop rebuilt at
 Park water
 Compt. No. 13-1921
 date of work beg. Oct. 1920
 Compt. Oct. 1920
 Office Dist. Engr. Spokane Wash.
 Scale: 1" = 100' 4220