

1923

NORTHERN PACIFIC RAILWAY COMPANY

AUTHORITY FOR EXPENDITURE

1923
Year: 1923

Superintendent's No. 104
No.

Dept. No. Engineering Dept. No. 102 2

A. F. E. No. 69

Minnesota Div. Red Lake Falls Branch State Minnesota Val. Sec. No. 16.

AUTHORITY IS REQUESTED FOR A NET EXPENDITURE OF \$ 95.

Accounting distribution as follows: (Distribution to be made in General Office.)

	Operating Expenses	Profit and Loss	Net Operating Expenses	Original Cost Actual to Date
Cost of property retired	\$	\$	\$	\$
Value of salvage				
Incidental costs				
Total to Operating Expenses				
Total to Profit and Loss				
To Material and Supplies				
To Bills for Collection				
To Other Accounts				
Net charge to investment account—Additions and Betterments				
Total of distribution				\$ 95

Budget reference: Not in Budget

Class of Work: No. 8

Joint facility contract reference: ~~102~~ Joint Account *E. M. Ry 4/16-1915*

The location is - - - on this company's property. To secure rights, it will be necessary

Location: **Perault (Near) - Minnesota.**

Title and Reason: **Perault (Near) - Widen Highway Crossing at M.P. 64 x 4930.**

In accordance with request of State Highway Department it is recommended planking in the highway crossing located at M.P. 64 x 4930, Red Lake Falls Branch, be extended 8 feet so as to make the crossing 24 feet to conform with width of public highway as graded. This will necessitate the extension of 24 inch tile pipe culverts on either side of track.

In accordance with Par. 4256, Laws Relating To The Railroad and Warehouse Commission, State of Minnesota.

Work to be done by ~~company~~ force under charge of Superintendent.

Accounting to concentrate in the office of Division Accountant Staples

Signature and Title: *E. M. Ry* Superintendent Date December 6th 1923.

APPROVED:

General Superintendent General Superintendent

Charles Amundson Engr. Maint. of Way.

Assistant General Manager Assistant General Manager

Chief Engineer Chief Engineer

General Manager General Manager

Vice President Vice President


General Auditor or Comptroller General Auditor or Comptroller

Charles Amundson President

Date of Final Approval } 12 23 19

COMPTROLLER'S RECORD OF NOTICE OF APPROVAL AND OF COMPLETION

Form No. 1345 issued *SAN 29 1923* 19 Work begun 19 Work finished *June 22, 1923*

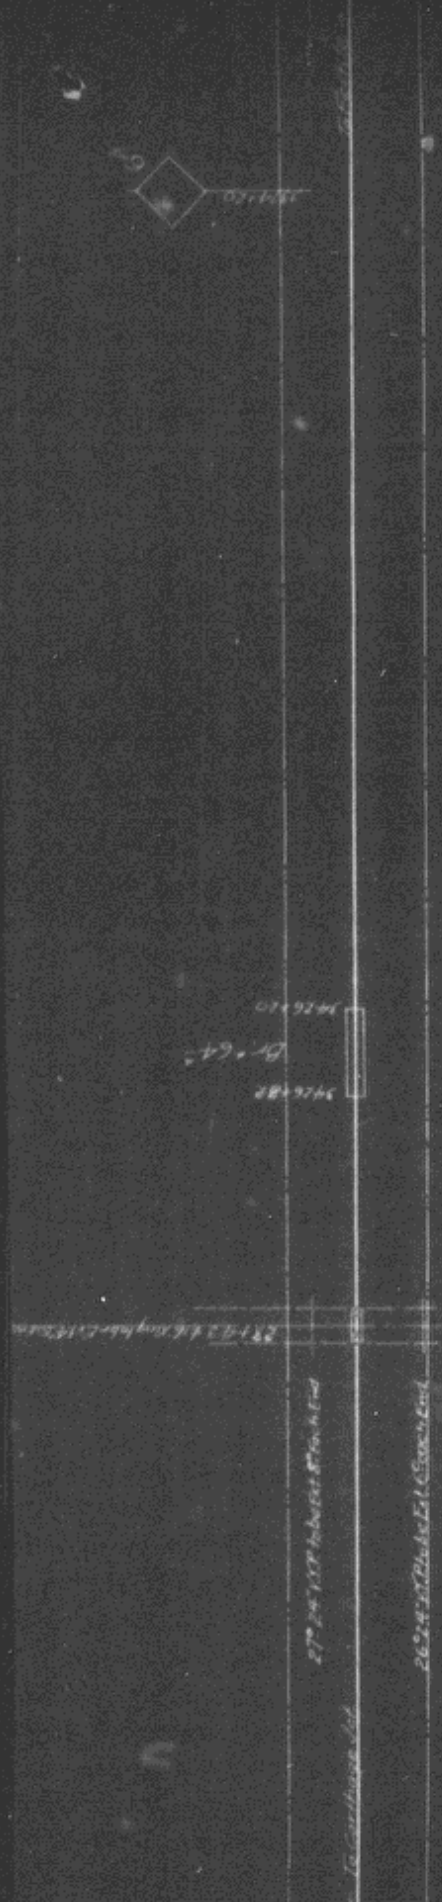

NPR₄

Minnesota Divn Red Lake Falls Branch

Prop'd Widen Hiway Xing at M.P. 64+49.30

near Perault

1"=100'

Office of Engr. St. Paul Nov 11-1922

Prop work shown Red

Val. Sec. N^o 16 Minn.