



N. P. 1365
8-24

NORTHERN PACIFIC RAILWAY COMPANY AUTHORITY FOR EXPENDITURE

COMPTROLLER'S COPY

SUPERINTENDENT NO. 163

1926
Montana

Div. Second

DEPT. No

ENGINEERING DEPT. No 17

1926 1926

A. F. E. NO. 112

DISTRICT STATE Montana VAL SEC. No. 3

AUTHORITY IS REQUESTED FOR A NET EXPENDITURE OF \$304

Accounting distribution as follows: (Distribution to be made in General Office.)

Cost of property retired	Operating Expenses	Profit and Loss	Net Operating Expenses	Net Profit and Loss
Value of salvage		900		
Incidental costs		352		
			548	
			48	

Total to Operating Expenses

Total to Profit and Loss

To Material and Supplies

To Bills for Collection

To Other Accounts

Net charge

Total of distribution

N. W. Packing Co.

P & L a/c 606



596

842

245

1032

1932

93

Budget reference: Not in budget

Joint facility contract reference: Not Joint

The location is on this company's property. To secure rights, it will be

Location: East Helena, Montana

Title: Remove Northwestern Packing Company Spur

Original Cost Adjustment
Made in MAY 1926

Reason: This spur was constructed under AFE 2299-18 for the Northwestern Packing Company. This spur has never been used for any purpose and to make material available for use, the portion of the spur from head block to right of way line was removed.

It is therefore recommended that work be approved as per attached blue prints and estimates.

Work completed November 7th, 1925.

Completed

Work done by company force under charge of Superintendent.

Accounting to concentrate in the office of Superintendent.

Signature and Title: *G. H. McCoy* Superintendent.

APPROVED: *W. H. Smith* General Superintendent. Date Dec. 30th 1925.

W. H. Smith General Superintendent. *W. H. Smith* Engr. Maint. of Way. General Manager.

W. H. Smith Chief Engineer. *W. H. Smith* Vice President.

W. H. Smith For Comptroller. *W. H. Smith* President.

Date of Final Approval JAN 30 1926

COMPTROLLER'S RECORD OF NOTICE OF APPROVAL AND OF COMPLETION

Form No. 1245 Issued 12 Work begun 12 Work finished 12

NPRy

Dring No.

2nd Dist

Proposed removal of Northwestern Rocking Co's spur
Mont Div
M.P. 233+54.4 near
East Helena


Scale: 1"=100'

Office of Dist Engr. Livingston, Mont. Nov. 25, 1925

Proposed removal shown

Valuation section - Mont. No. 3.

Note: Work completed to Pw line Nov. 7, 1925.

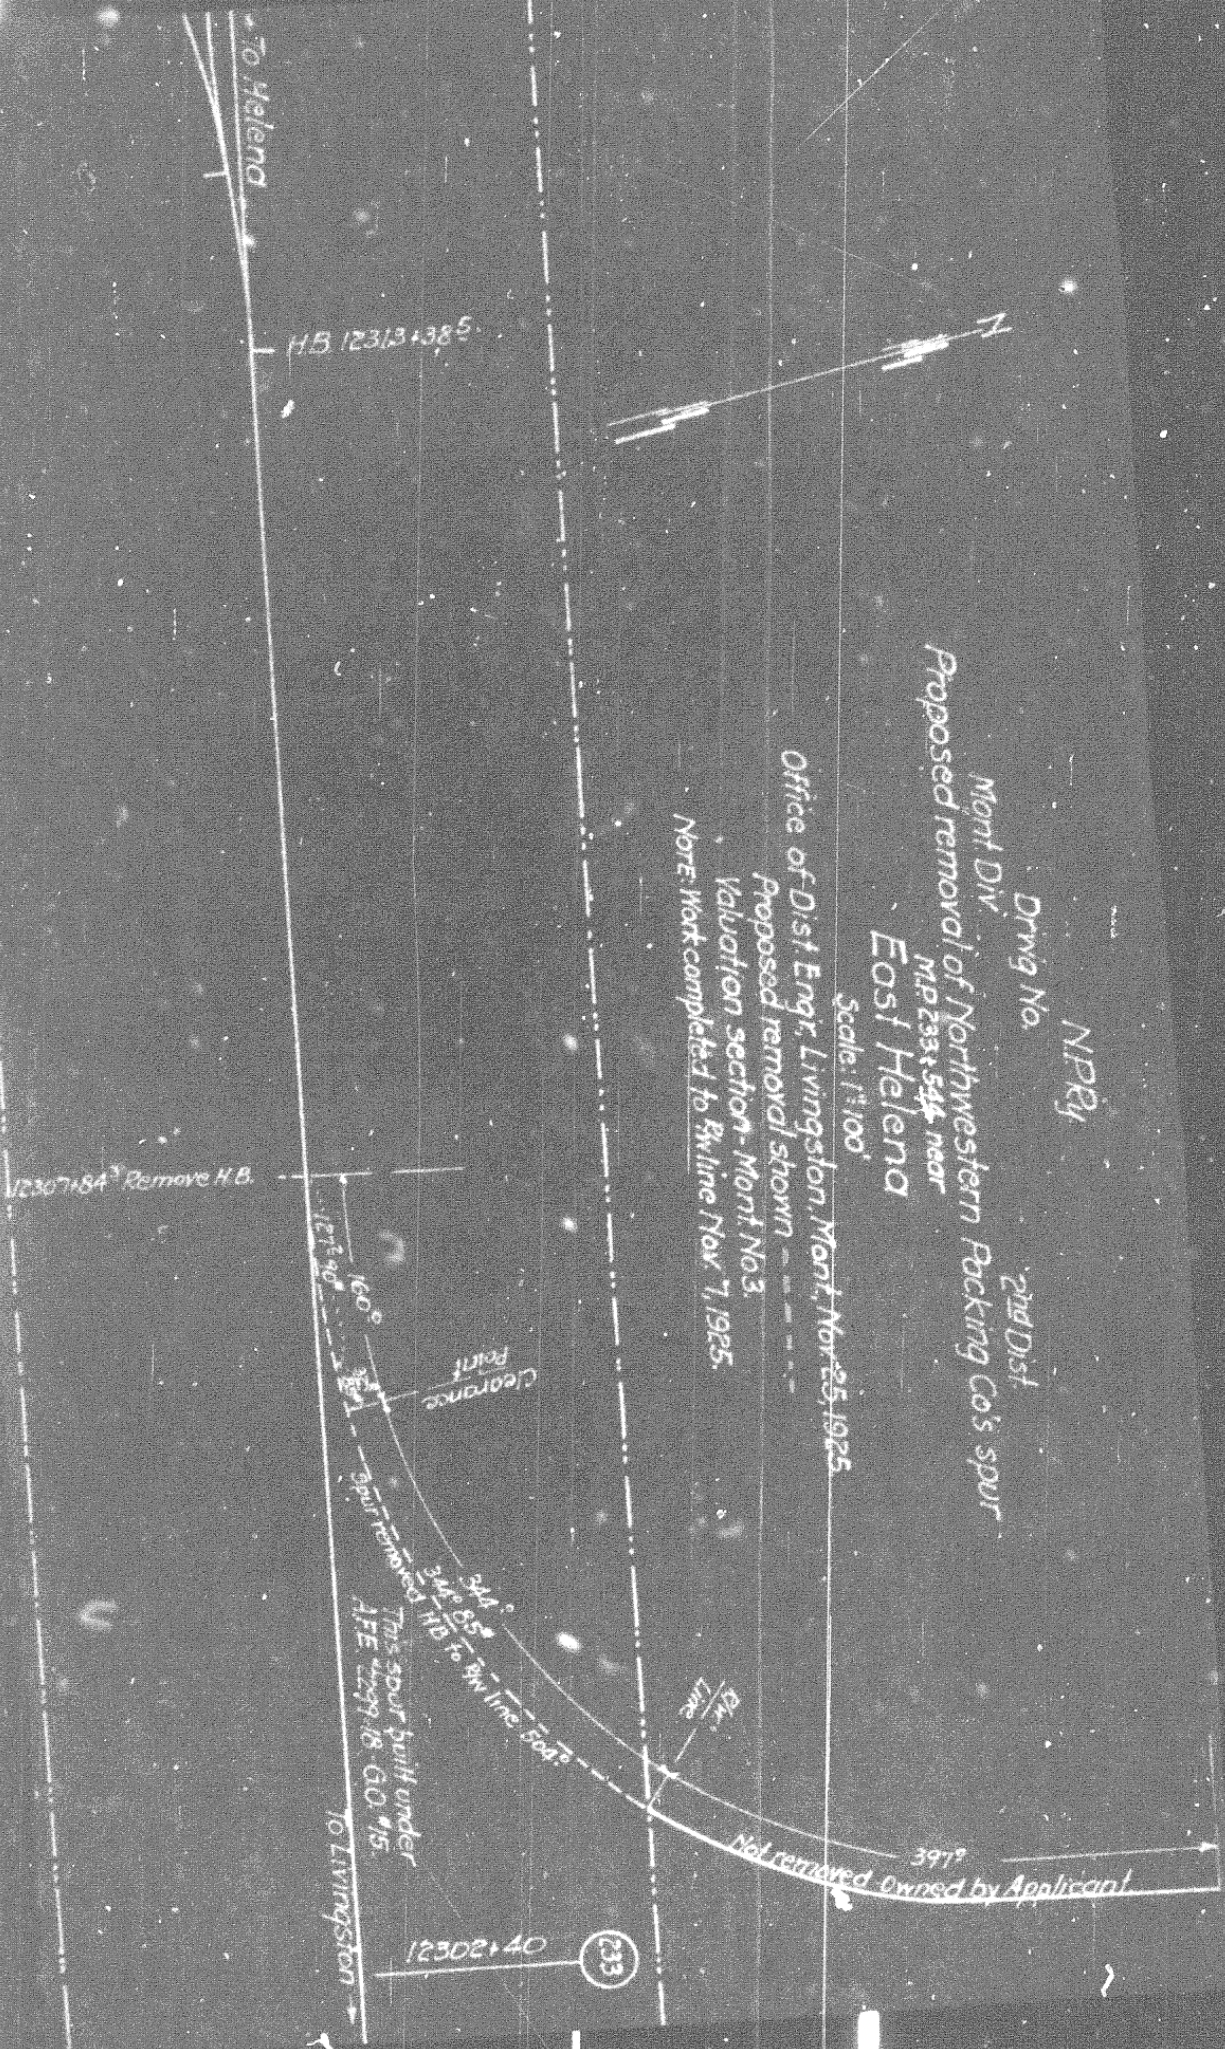

2nd Dist.

Mont. Div. Z. Dist.
Remove Northwestern Packing Company's Spur
at

East Helena

Scale: 1"=100'

Scale 1-100
Office of Dist. Eng. Livingston Mont. April 26, 1926.
Removals shown

Removal's shown

Validation section	Montana No 3
Auth. under 1919	dated 1-30-26
Work begun	November 1925
Work completed	November 7, 1925

EAST HELENA

→ *To Helena*

H.B. 12313-38⁵

H.B. 12307-84? removed

To Livingston

