



N. P. 1363
6-24

NORTHERN PACIFIC RAILWAY COMPANY AUTHORITY FOR EXPENDITURE

SUPERINTENDENT'S No. 3
No.

1929

DEPT. No.

ENGINEERING DEPT. No. 24-29

1929
YEAR 1929

A. F. E. No. 223

Seattle Div.

First

DISTRICT STATE Wash

VAL. SEC. No. 2

AUTHORITY IS REQUESTED FOR A NET EXPENDITURE OF \$ 827

Accounting distribution as follows: (Distribution to be made in General Office.)

Cost of property retired	Operating Expenses	Profit and Loss	Net Operating Expenses	Net Profit and Loss
Value of salvage				
Incidental costs				
Total to Operating Expenses				
Total to Profit and Loss				
To Material and Supplies				
To Bills for Collection				
To Other Accounts				
Net charge to investment account—Additions and Betterments				
Total of distribution				

Original Cost Adjustment
Made in 12-2-1929
Ginnel

Budget reference: NOT IN BUDGET.

Joint facility contract reference: Non Joint.

Class of Works No. 15

The location is _____ on this company's property. To secure rights, it will be necessary

Location: Easton, Washington.
Title: Watchman's Bunk House

Reason: On March 3rd, 1928 the shacks used by watchmen at Tunnel #2 near Easton were destroyed by fire and as it is necessary to maintain watchmen at that point a standard bunk house was constructed to replace the ones destroyed. The old shacks had been constructed of odds and ends by the watchmen and were not included in capital account. Tunnel #2 is an isolated point and watchmen cannot be kept there without a bunk house. This RFA is prepared to cover bunk house constructed during June 1928.

COMPLETED

Work to be done by _____ force under charge of Divn. Superintendent at Seattle, Wn.

Accounting to concentrate in the office of Divn. Accountant at Seattle, Wn.

Signature and Title: J.R. Bartley, Div. Superintendent



Supt Date Jan. 4 29

APPROVED: General Superintendent, Asst. Chief Engr. or Engr. Maint. of Way, General Manager

Mech. Supt., Supt. Telgr. or Signal Engr., Chief Engineer, Vice President

For Comptroller: Charles Souney, President


Date of Final Approval: FEB 5 1929

Form No. 1345 issued

COMPTROLLER'S RECORD OF NOTICE OF APPROVAL AND OF COMPLETION

19 Work begun

19 Work finished June 29 29

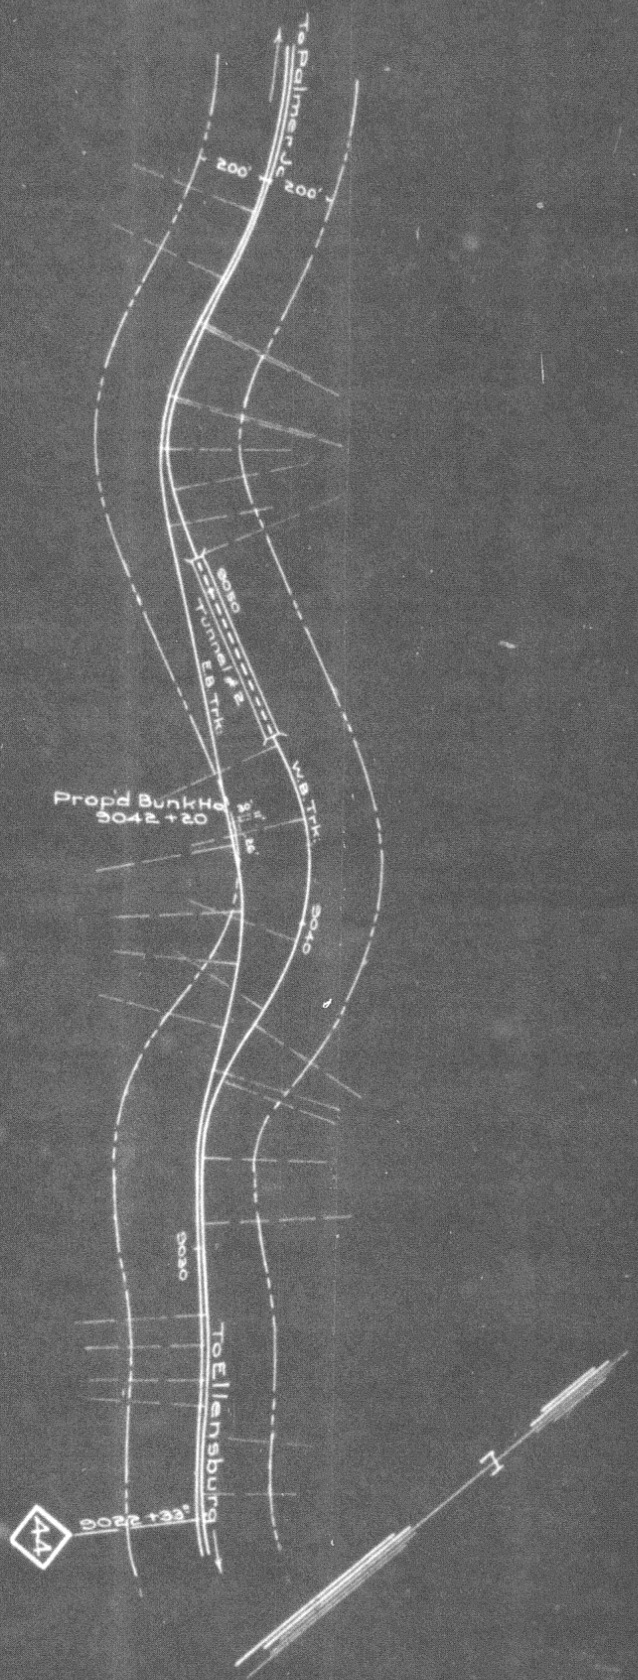

Std: Bunk House Sht: 293 Modified
 Replaces shacks 'six' & 'six'
 Destroyed by fire

Work completed

N.P.R.
 Seattle Div. First District
 Wash. Val. Sec. 2
 Sketch showing Watchman's
 Bunk House at Tunnel No. 2
 Office of Dist. Engr. Seattle Wn.
 Scale 1" = 400' Dec. 28 1929