



N. P. 1363
6-24

NORTHERN PACIFIC RAILWAY COMPANY

COMPTROLLER'S COPY

AUTHORITY FOR EXPENDITURE

1929 1929
YEAR 1929

SUPERINTENDENT'S NO. 51

DEPT. NO.

A. F. E. NO.

270

No. 1

ENGINEERING DEPT. NO. 49

Yellowstone Div.

Third

DISTRICT STATE
~~BRANCK~~ ^{Montana}

NO. 1000 VAL. SEC. NO. 1

AUTHORITY IS REQUESTED FOR A NET EXPENDITURE OF \$ 590.

Accounting distribution as follows: (Distribution to be made in General Office.)

| | Operating Expenses | Profit and Loss | Net Operating Expenses | Net Profit and Loss |
|--|--------------------|-----------------|------------------------|---------------------|
| Cost of property retired | \$ | \$ | \$ | \$ |
| Value of salvage | | | | |
| Incidental costs | | | | \$ |
| Total to Operating Expenses | | | | |
| Total to Profit and Loss | | | | |
| To Material and Supplies | | | | |
| To Bills for Collection | | | | |
| To Other Accounts | | | | |
| Net charge to investment account—Additions and Betterments | | | | \$ 590 ✓ |
| Total of distribution | | | | \$ 590 ✓ |

Class of Works No. 21 ✓

Budget reference: Not budget item

Joint facility contract reference: Not joint account

The location is -- on this company's property. To secure rights, it will be necessary to do nothing

Location: Glendale

Title: Estimated cost proposed installation of D&M cleaning machine platform, as per sketch dated January 7, 1929.

Reason:

Some time ago the Mechanical Department made arrangements for the installation of a D&M cleaning machine at the Glendale Roundhouse. This arrangement was made on a rental basis but it was necessary for us to provide a platform on which to install machine and to provide proper drainage on account of the water used. The work was completed August 1928.

Work to be done by ^{COMPLETED} company force under charge of ~~REPAIRS~~ Division Superintendent

Accounting to concentrate in the office of

Division Superintendent

Checked and Entered
President's Office

Date Jan 10th 1929

Signature and Title:

P. T. Taylor Supt

APPROVED:

M. J. ...
General Superintendent

J. ...
Asst. Chief Engr. or Engr. in Charge of Work

E. S. ...
General Manager

Mech. Supt., Supt. Telgr. or Signal Engr.

D. ...
Chief Engineer

H. Z. ...
Vice President

W. ...
For Comptroller

Charles ...
President

Date of Final Approval

FEB 25 1929

COMPTROLLER'S RECORD OF NOTICE OF APPROVAL AND OF COMPLETION


Form No. 1345 issued

19 Work begun

19 Work finished

Feb. 22 1928



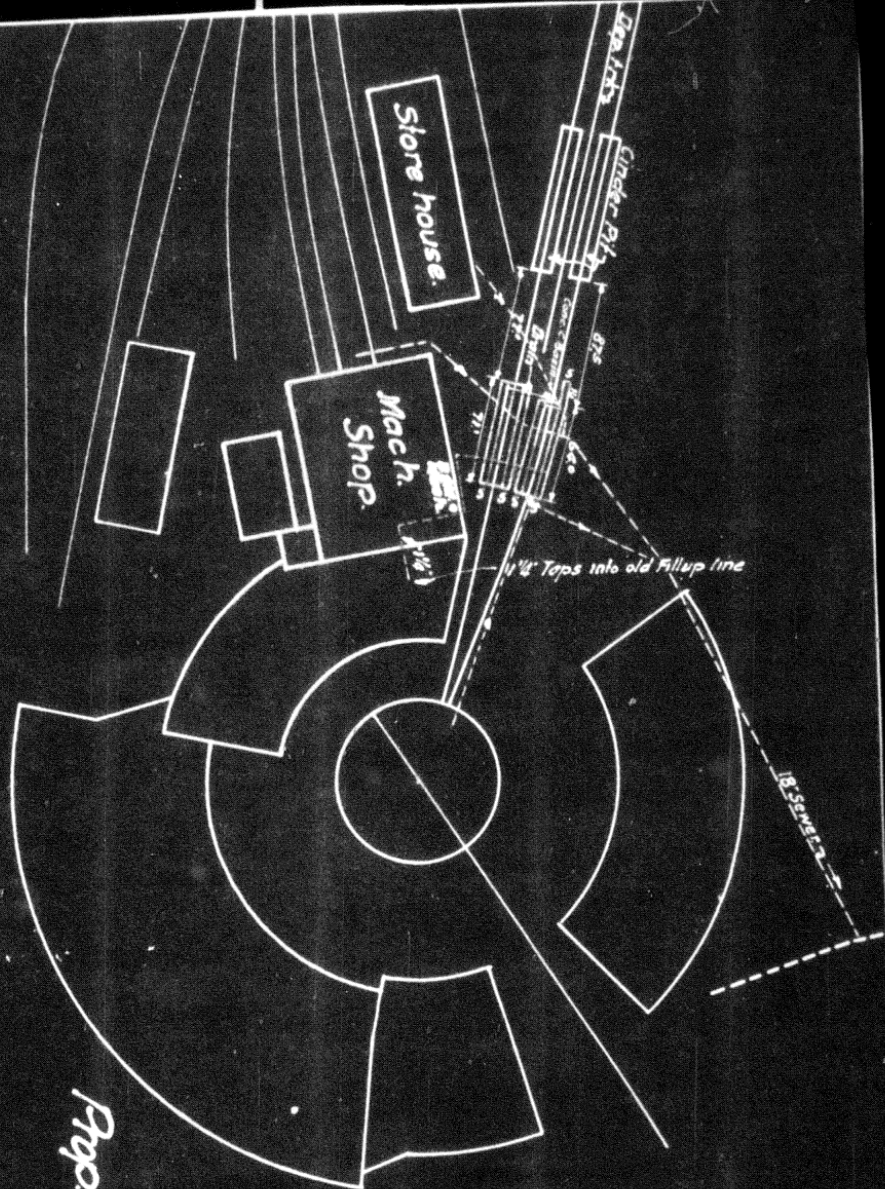

*Prop. Installation of D & M. Cleaning
Machine Platform
of
Glendive.*

*Scale: 1" = 100 ft.
Office of Dist. Engr. Livingston, Mont. Jan. 7th 1929.
Proposed New work Shown
Valuation Section Mont. No 1
Work Completed in 1928.*

*N.P.R.Y.
Drawing No
Yellowstone Div
3rd District.*

