



N. P. 1363
6-24

NORTHERN PACIFIC RAILWAY COMPANY
AUTHORITY FOR EXPENDITURE

COMPTROLLER'S COPY

SUPERINTENDENT'S No.

No.

DEPT. No.

ENGINEERING DEPT. No. 8

YEAR

A. F. E. NO. 28

Lake Superior DIV.

Cuyuna Northern

DISTRICT

BRANCH

STATE Minn

VAL. SEC. No. 12 A

AUTHORITY IS REQUESTED FOR A NET EXPENDITURE OF \$ 578

Accounting distribution as follows: (Distribution to be made in General Office.)

Cost of property retired	Operating Expenses	Profit and Loss	Net Operating Expenses	Net Profit and Loss
Value of salvage				
Incidental costs				
Total to Operating Expenses				
Total to Profit and Loss				
To Material and Supplies				
To Bills for Collection				
To Other Accounts				\$ 578 ✓
Net charge to investment account—Additions and Betterments				578 ✓
Total of distribution				\$ 1156 ✓

Budget reference:

Item 271-31

Class of Works No. 10 ✓

Joint facility contract reference:

Joint with Soo Line - Contract June 11 1928

The location is not on this company's property. To secure rights, it will be necessary

Location: Ironton

Title Crossover and turnout at Evergreen Mine

and

Reason:

The Evergreen Mining Company requests the construction of a crossover between loading Tracks 1 and 2 adjacent to the sintering plant so as to provide additional room for loads. It also wants a switch placed in the loading track, which the Mining Company will extend so that a car can be spotted to load ore that falls from cars in the yard and is to be picked up.

The Mining Company has agreed to furnish the labor for this trackage if the Railway Company will furnish the material. The crossover has already been constructed under this arrangement.

partly completed
Work ~~ORDERED~~ by company force under charge of Div Supt

Accounting to concentrate in the office of Div Acct - Duluth

Signature and Title: *W. M. Beach*

AFE Section

Date Dec 27 1930

APPROVED:

H. A. Strachan
Asst. General Superintendent

J. T. Denig
Asst. Chief Engr. in Charge, Maint. of W.

W. C. M. M.
General Manager

Mech. Supt., Surf., Tel. or Signal Engr.

D. M. H. H.
Chief Engineer

W. M. Beach
For Controller

Charles D. M. M.
President

H. E. H. H.
Vice President

Date of Final Approval { } 1930

COMPTROLLER'S RECORD OF NOTICE OF APPROVAL AND OF COMPLETION


Form No. 1345 Issued

19 Work begun


19

Work finished

1930

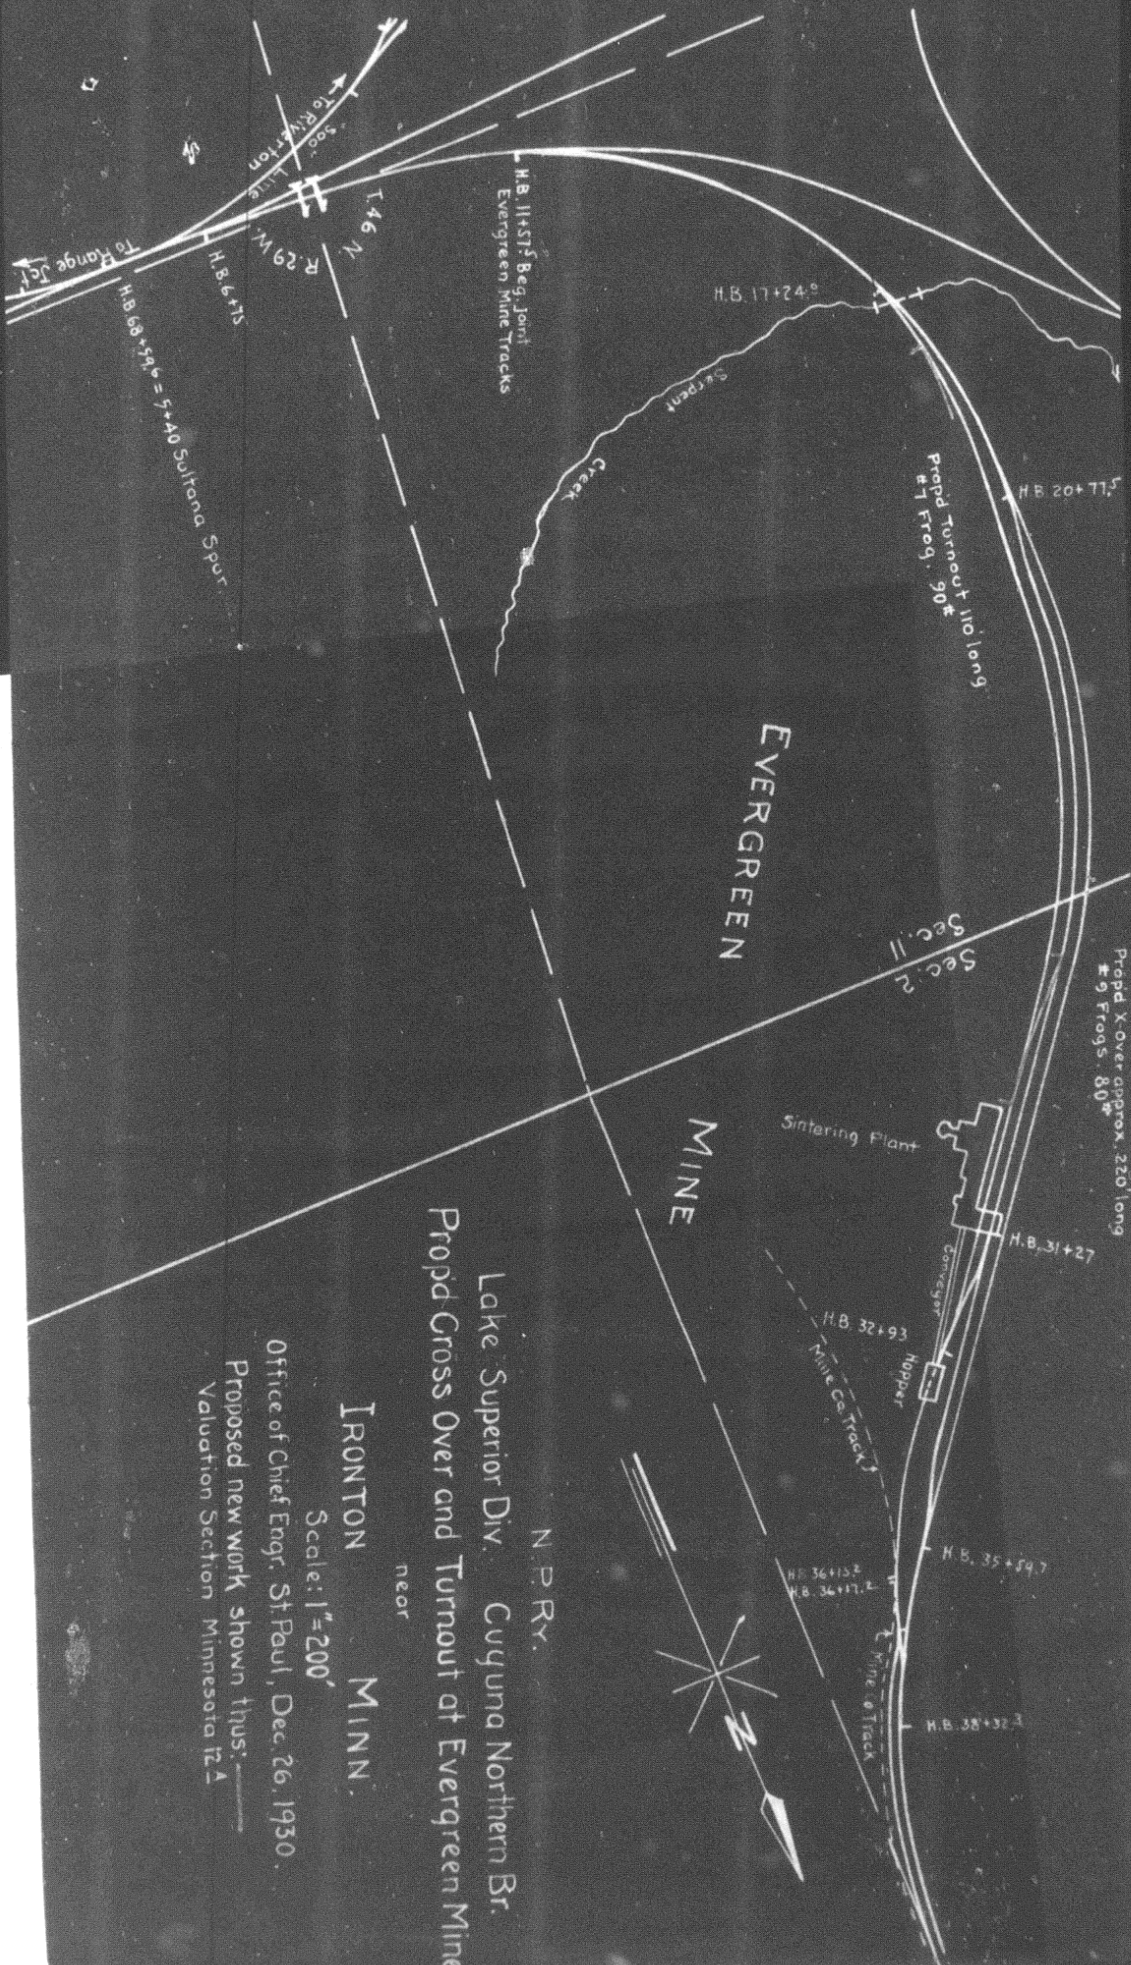

28-31

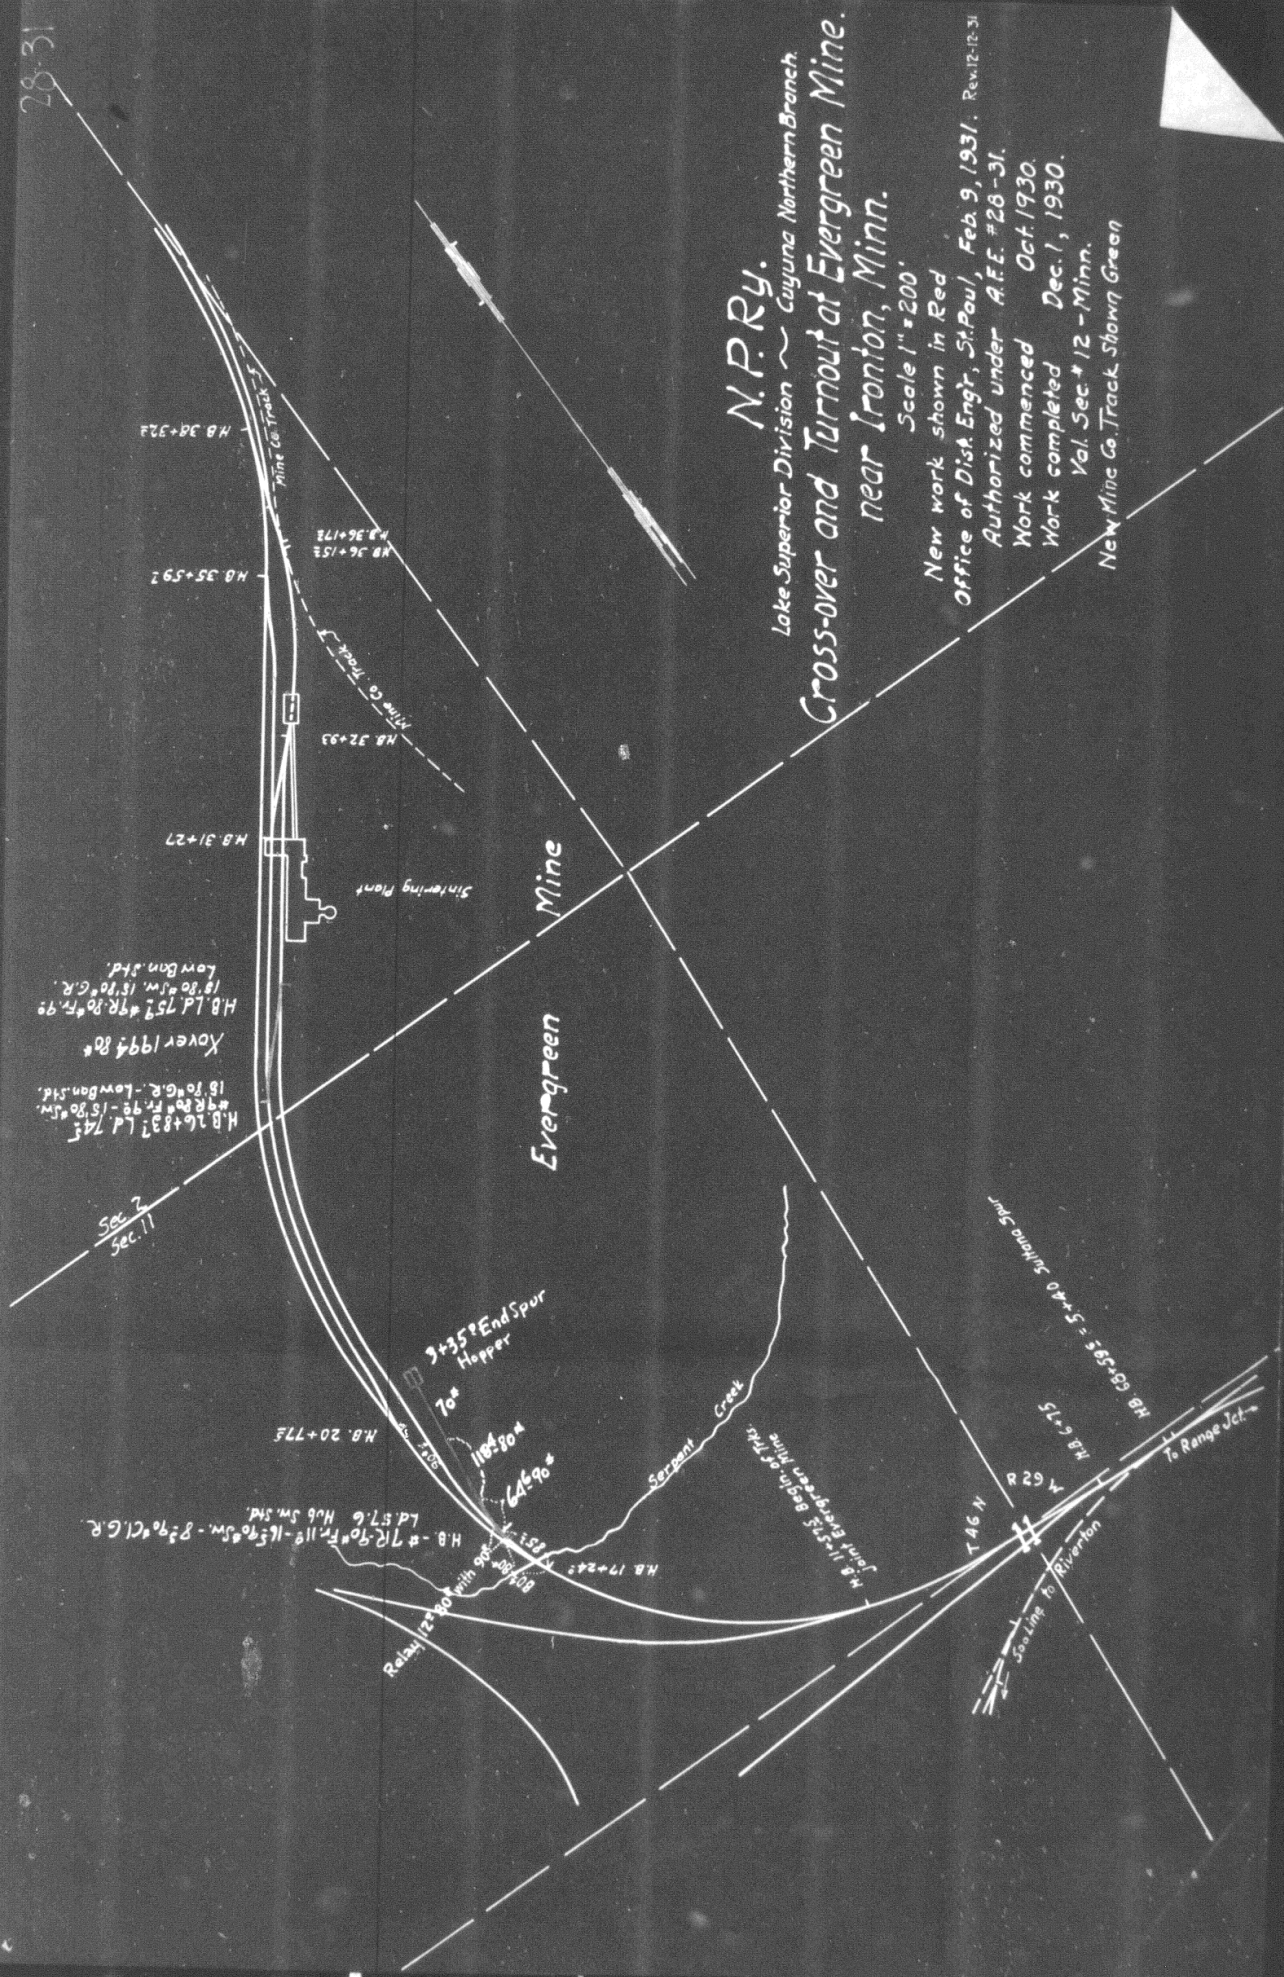

N.P.Ry.

Lake Superior Division ~ Cuyuna Northern Branch.
Cross-over and Turnout at Evergreen Mine.
near Ironton, Minn.

Scale 1"=200'

New work shown in Red

Office of Dist. Engr., St. Paul, Feb. 9, 1931. Rev. 12-12-31

Authorized under A.E.E. #28-31.

Work commenced Oct. 1930.

Work completed Dec. 1, 1930.

Val. Sec. # 12 - Minn.

New Mine Co. Track Shown Green